SUBDIVSION
of
Lots. 7 8 9. AND 10 Block 6

JACOBSVILLE

As laid out by the proprietor thereof

F. J. Moores

Maryland Street

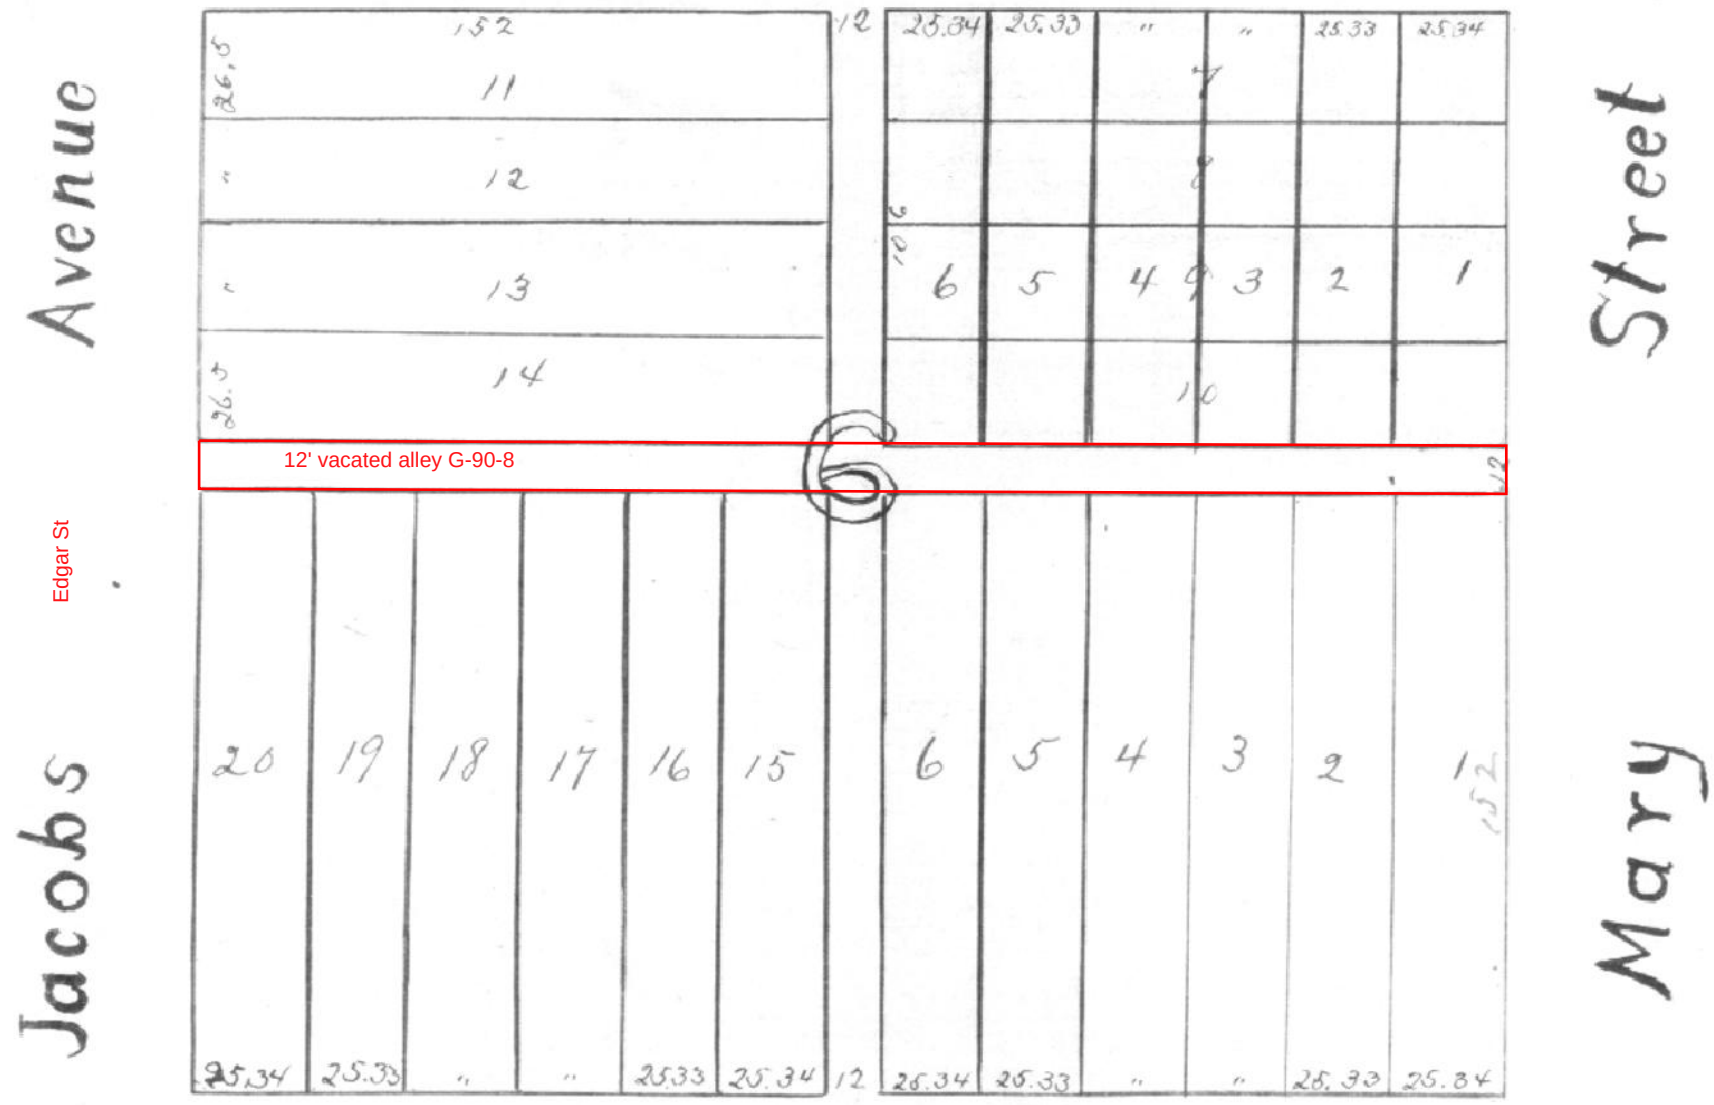

Columbia Street

State of Indiana } ss:
Vanderburgh County }

Personally appeared F. J. Moores before the undersigned Recorder in and for said County this 10" day of October 1891. and acknowledged the execution of the annexed and foregoing Plat Witness my hand and Official seal

Paul. De Hess
R.V.C

Recorded Oct 10" 1891
Paul. De Hess
R.V.C